P-14

PHELPS DODGE 3 USFS, COCONINO CO.
13N-11E-5 NW SW SW File 3-15

P

3-15

Strat(mineral) Test
~~WATER WELL INFORMATION SHEET~~

File No. ~~204~~ void
Strat(mineral)test

County Coconino

Area

Well Owner Phelps Dodge 3 USFS

API # 02-005-05095

LOCATION

T R S	Quadrangle, District, and Field Number or Name	Miles West and South of Northeast Corner of Quadrangle
13n- 11e - 5 NW SW SW		est. 800 fsl 500 fwl

Total Depth	Elevation	Samples of Drill-Bit Cuttings and/or Cores
450	7030 GL KB	No Yes Sample File No.

LOGS

Elec Logs	Lithologic	Driller's

GEOLOGICAL

Formation Tops	Depth			Remarks
	Elec Logs	Lithologic	Driller's	
Pk			0-315	
Pro			315-450	

Source of Formation Top Data: USGS 4PD Fig.

GENERAL

7030
315
6715

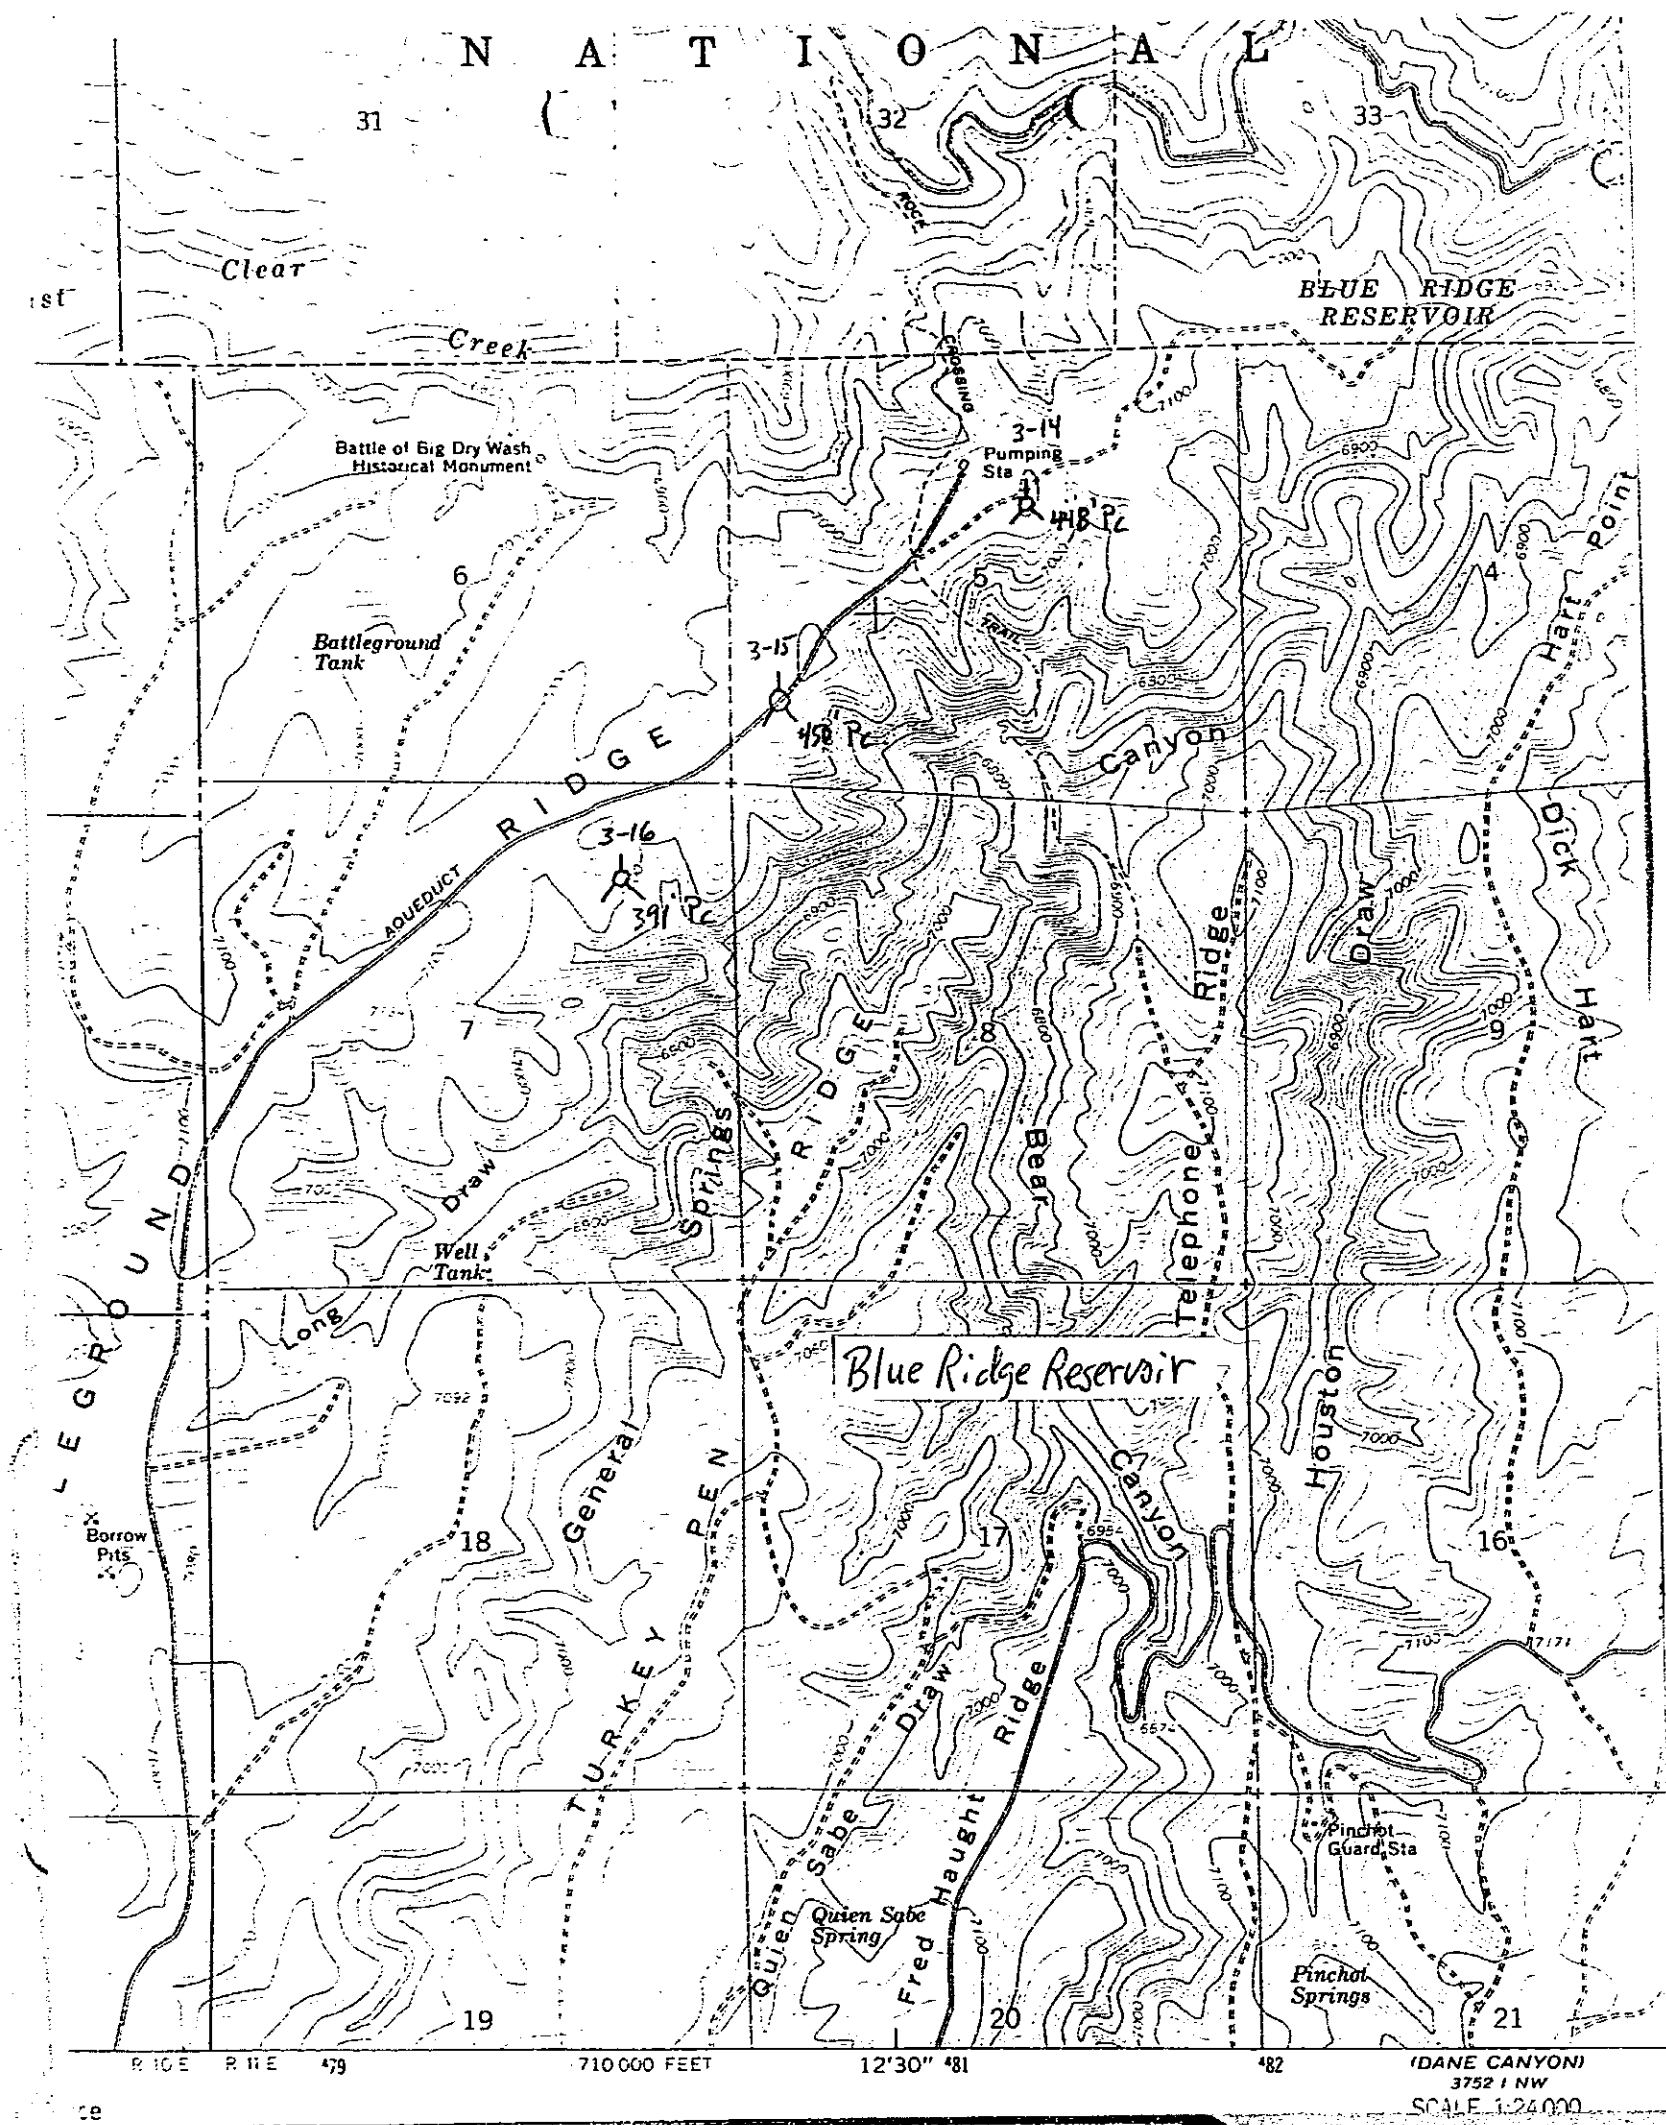
N A T I O N A L
31
32
33
Clear
Creek
BLUE RIDGE
RESERVOIR
Battle of Big Dry Wash
Historical Monument
3-14
Pumping
Sta
418' Pc
6
5
4
Battleground
Tank
3-15
458' Pc
Canyon
Hart
Point
RIDGE
AQUEDUCT
3-16
391' Pc
Dick
Hart
Ridge
Draw
7
8
9
Springs
RIDGE
Bear
Telephone
Draw
Well
Tank
Long
Blue Ridge Reservoir
General
TURKEY PEN
Canyon
Houston
Borrow
Pits
18
17
16
Draw
Ridge
Quien Sabe
Fred Haught
Pinchot
Guard Sta
Quien Sabe
Spring
Pinchot
Springs
19
20
21
R 10 E
R 11 E
479
710 000 FEET
12'30"
481
482
(DANE CANYON)
3752 I NW
SCALE 1:24 000